TURN OFF ALL POWER BLOCK EQUIP BUT PAD

HAVE EXISTING TANKS BERMS SHOWING

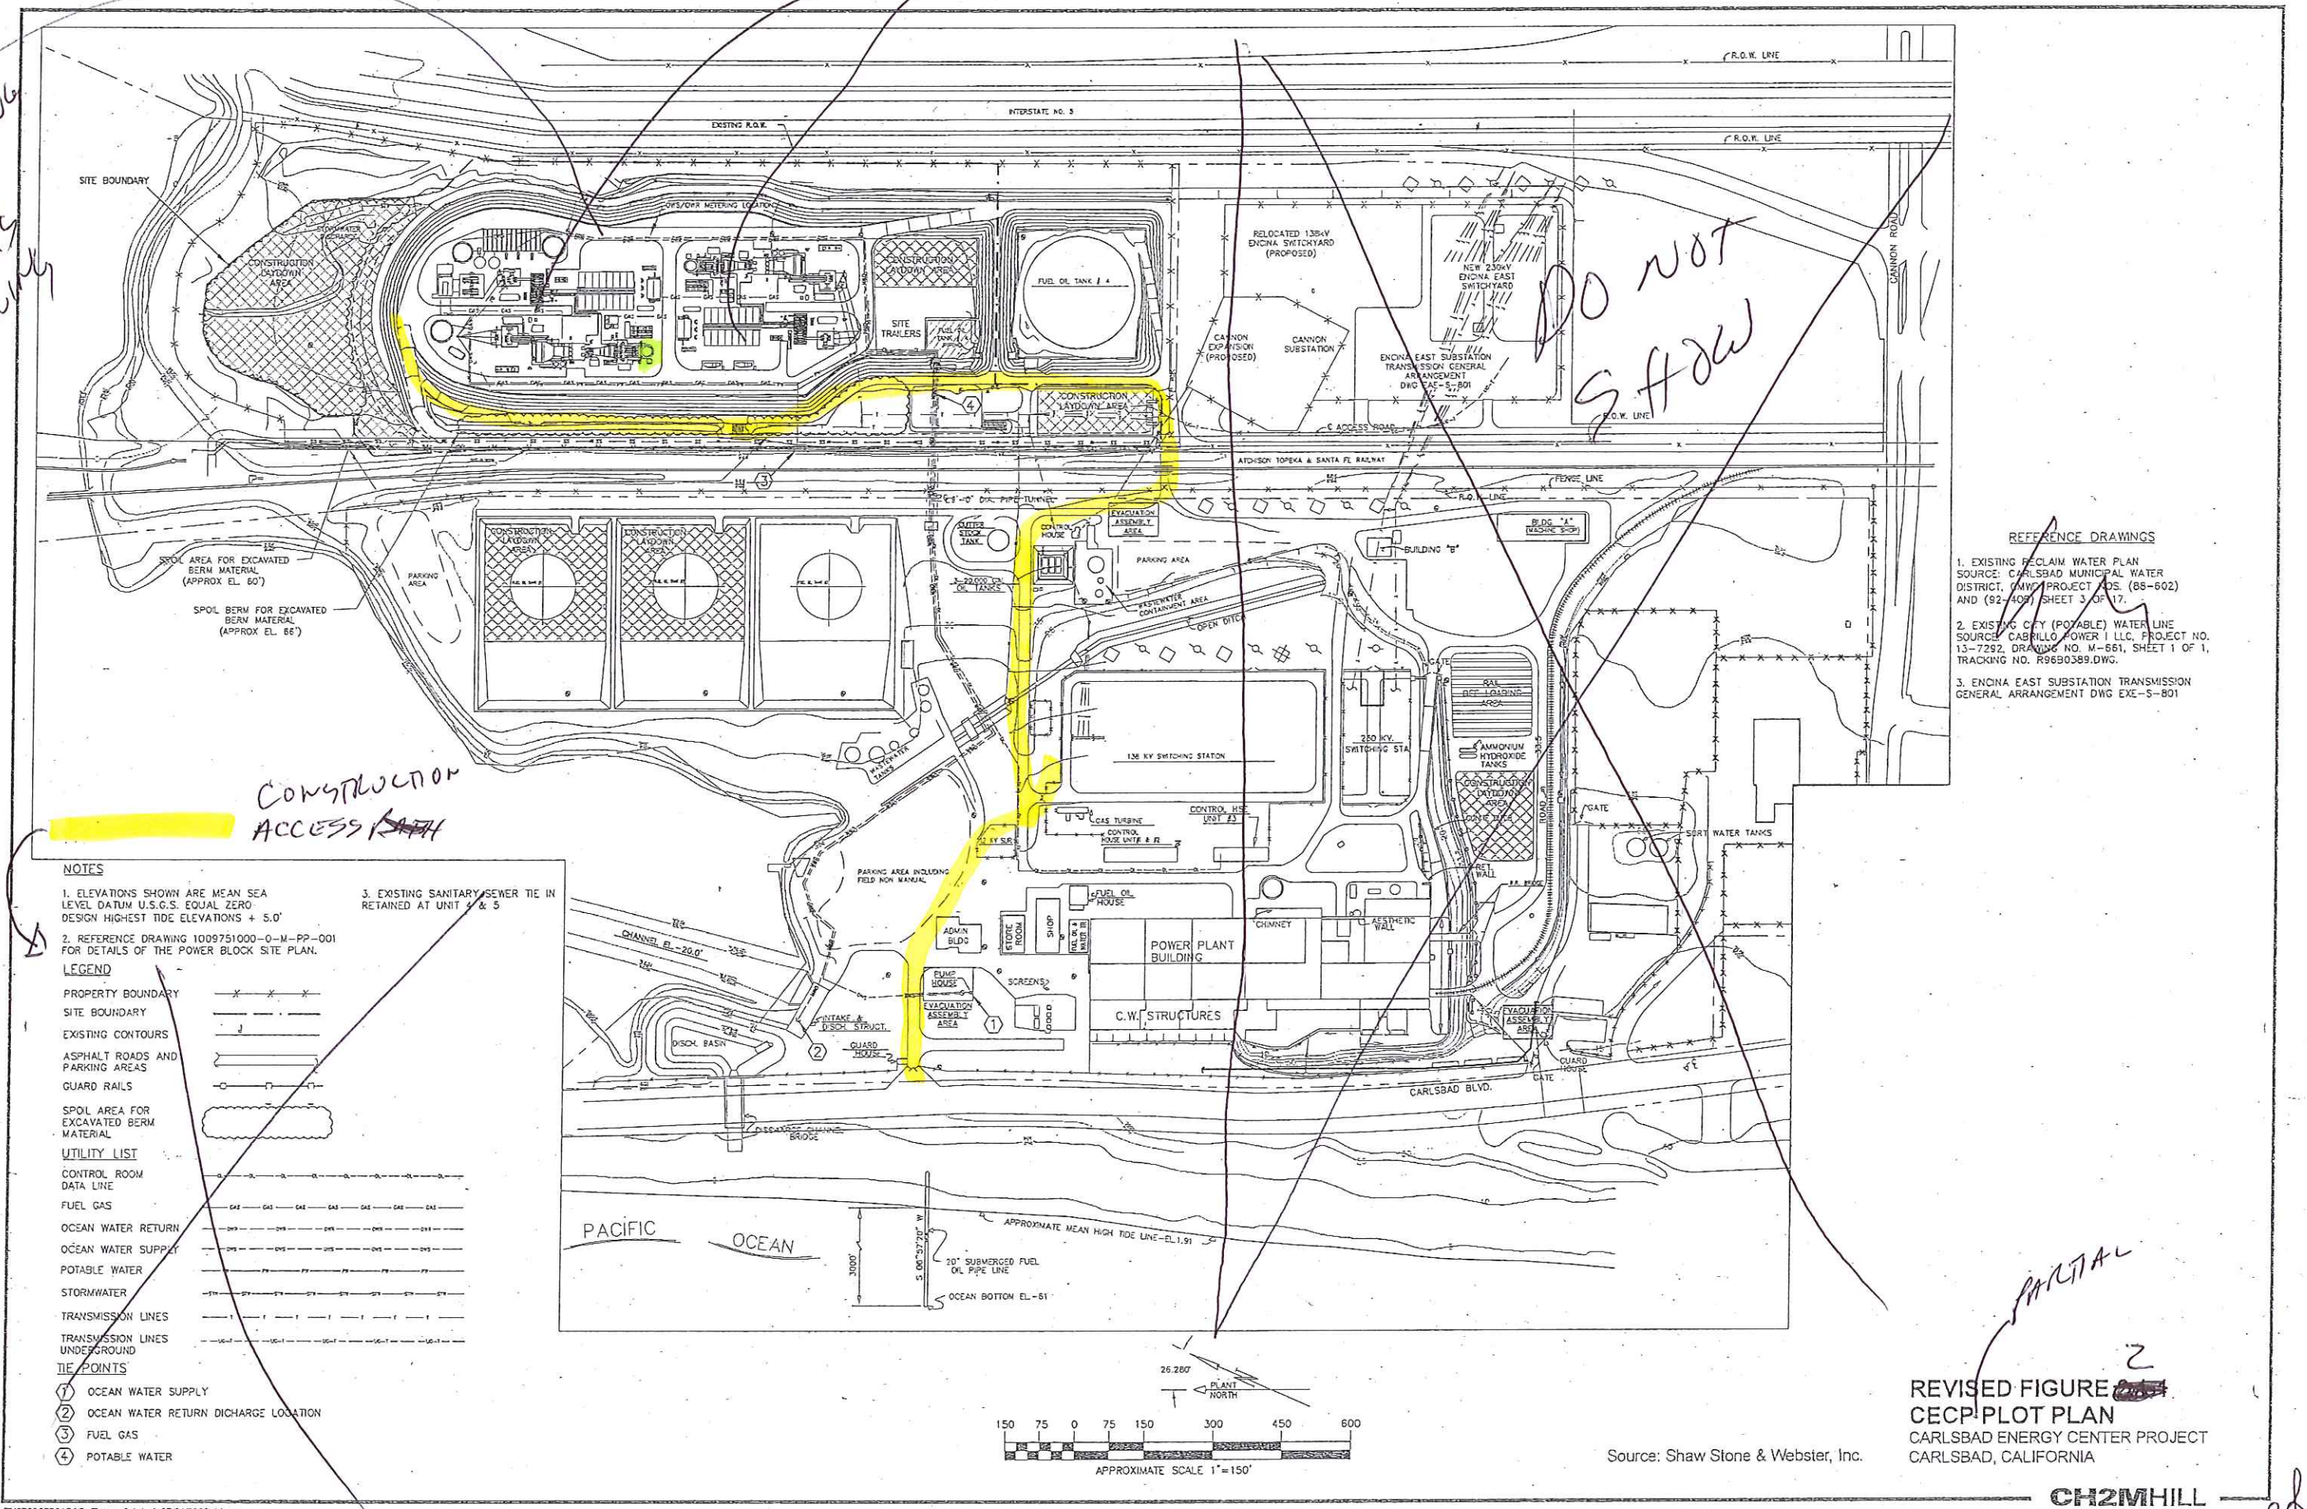

DO NOT SHOW

NOTES

1. ELEVATIONS SHOWN ARE MEAN SEA LEVEL DATUM U.S.G.S. EQUAL ZERO DESIGN HIGHEST TIDE ELEVATIONS + 5.0'
2. REFERENCE DRAWING 1009751000-0-M-PP-001 FOR DETAILS OF THE POWER BLOCK SITE PLAN.
3. EXISTING SANITARY SEWER TIE IN RETAINED AT UNIT 4 & 5

LEGEND

- PROPERTY BOUNDARY
- SITE BOUNDARY
- EXISTING CONTOURS
- ASPHALT ROADS AND PARKING AREAS
- GUARD RAILS
- SPOIL AREA FOR EXCAVATED BERM MATERIAL

UTILITY LIST

- CONTROL ROOM DATA LINE
- FUEL GAS
- OCEAN WATER RETURN
- OCEAN WATER SUPPLY
- POTABLE WATER
- STORMWATER
- TRANSMISSION LINES
- TRANSMISSION LINES UNDERGROUND

TIE POINTS

1. OCEAN WATER SUPPLY
2. OCEAN WATER RETURN DICHARGE LOCATION
3. FUEL GAS
4. POTABLE WATER

REFERENCE DRAWINGS

1. EXISTING RECLAIM WATER PLAN SOURCE: CARLSBAD MUNICIPAL WATER DISTRICT, CMWD PROJECT NOS. (88-602) AND (92-409) SHEET 3 OF 17.
2. EXISTING CITY (POTABLE) WATER LINE SOURCE: CABRILLO POWER I LLC, PROJECT NO. 13-7292, DRAWING NO. M-661, SHEET 1 OF 1, TRACKING NO. R96B0389.DWG.
3. ENCINA EAST SUBSTATION TRANSMISSION GENERAL ARRANGEMENT DWG EXE-S-801

PARTIAL

REVISED FIGURE 2
CECP PLOT PLAN
CARLSBAD ENERGY CENTER PROJECT
CARLSBAD, CALIFORNIA

Source: Shaw Stone & Webster, Inc.

CH2MHILL

EY072007001SAC Figure_2.1-1.ai 07/21/2008 tdaus

EJH 6/22/11